Bilag 1

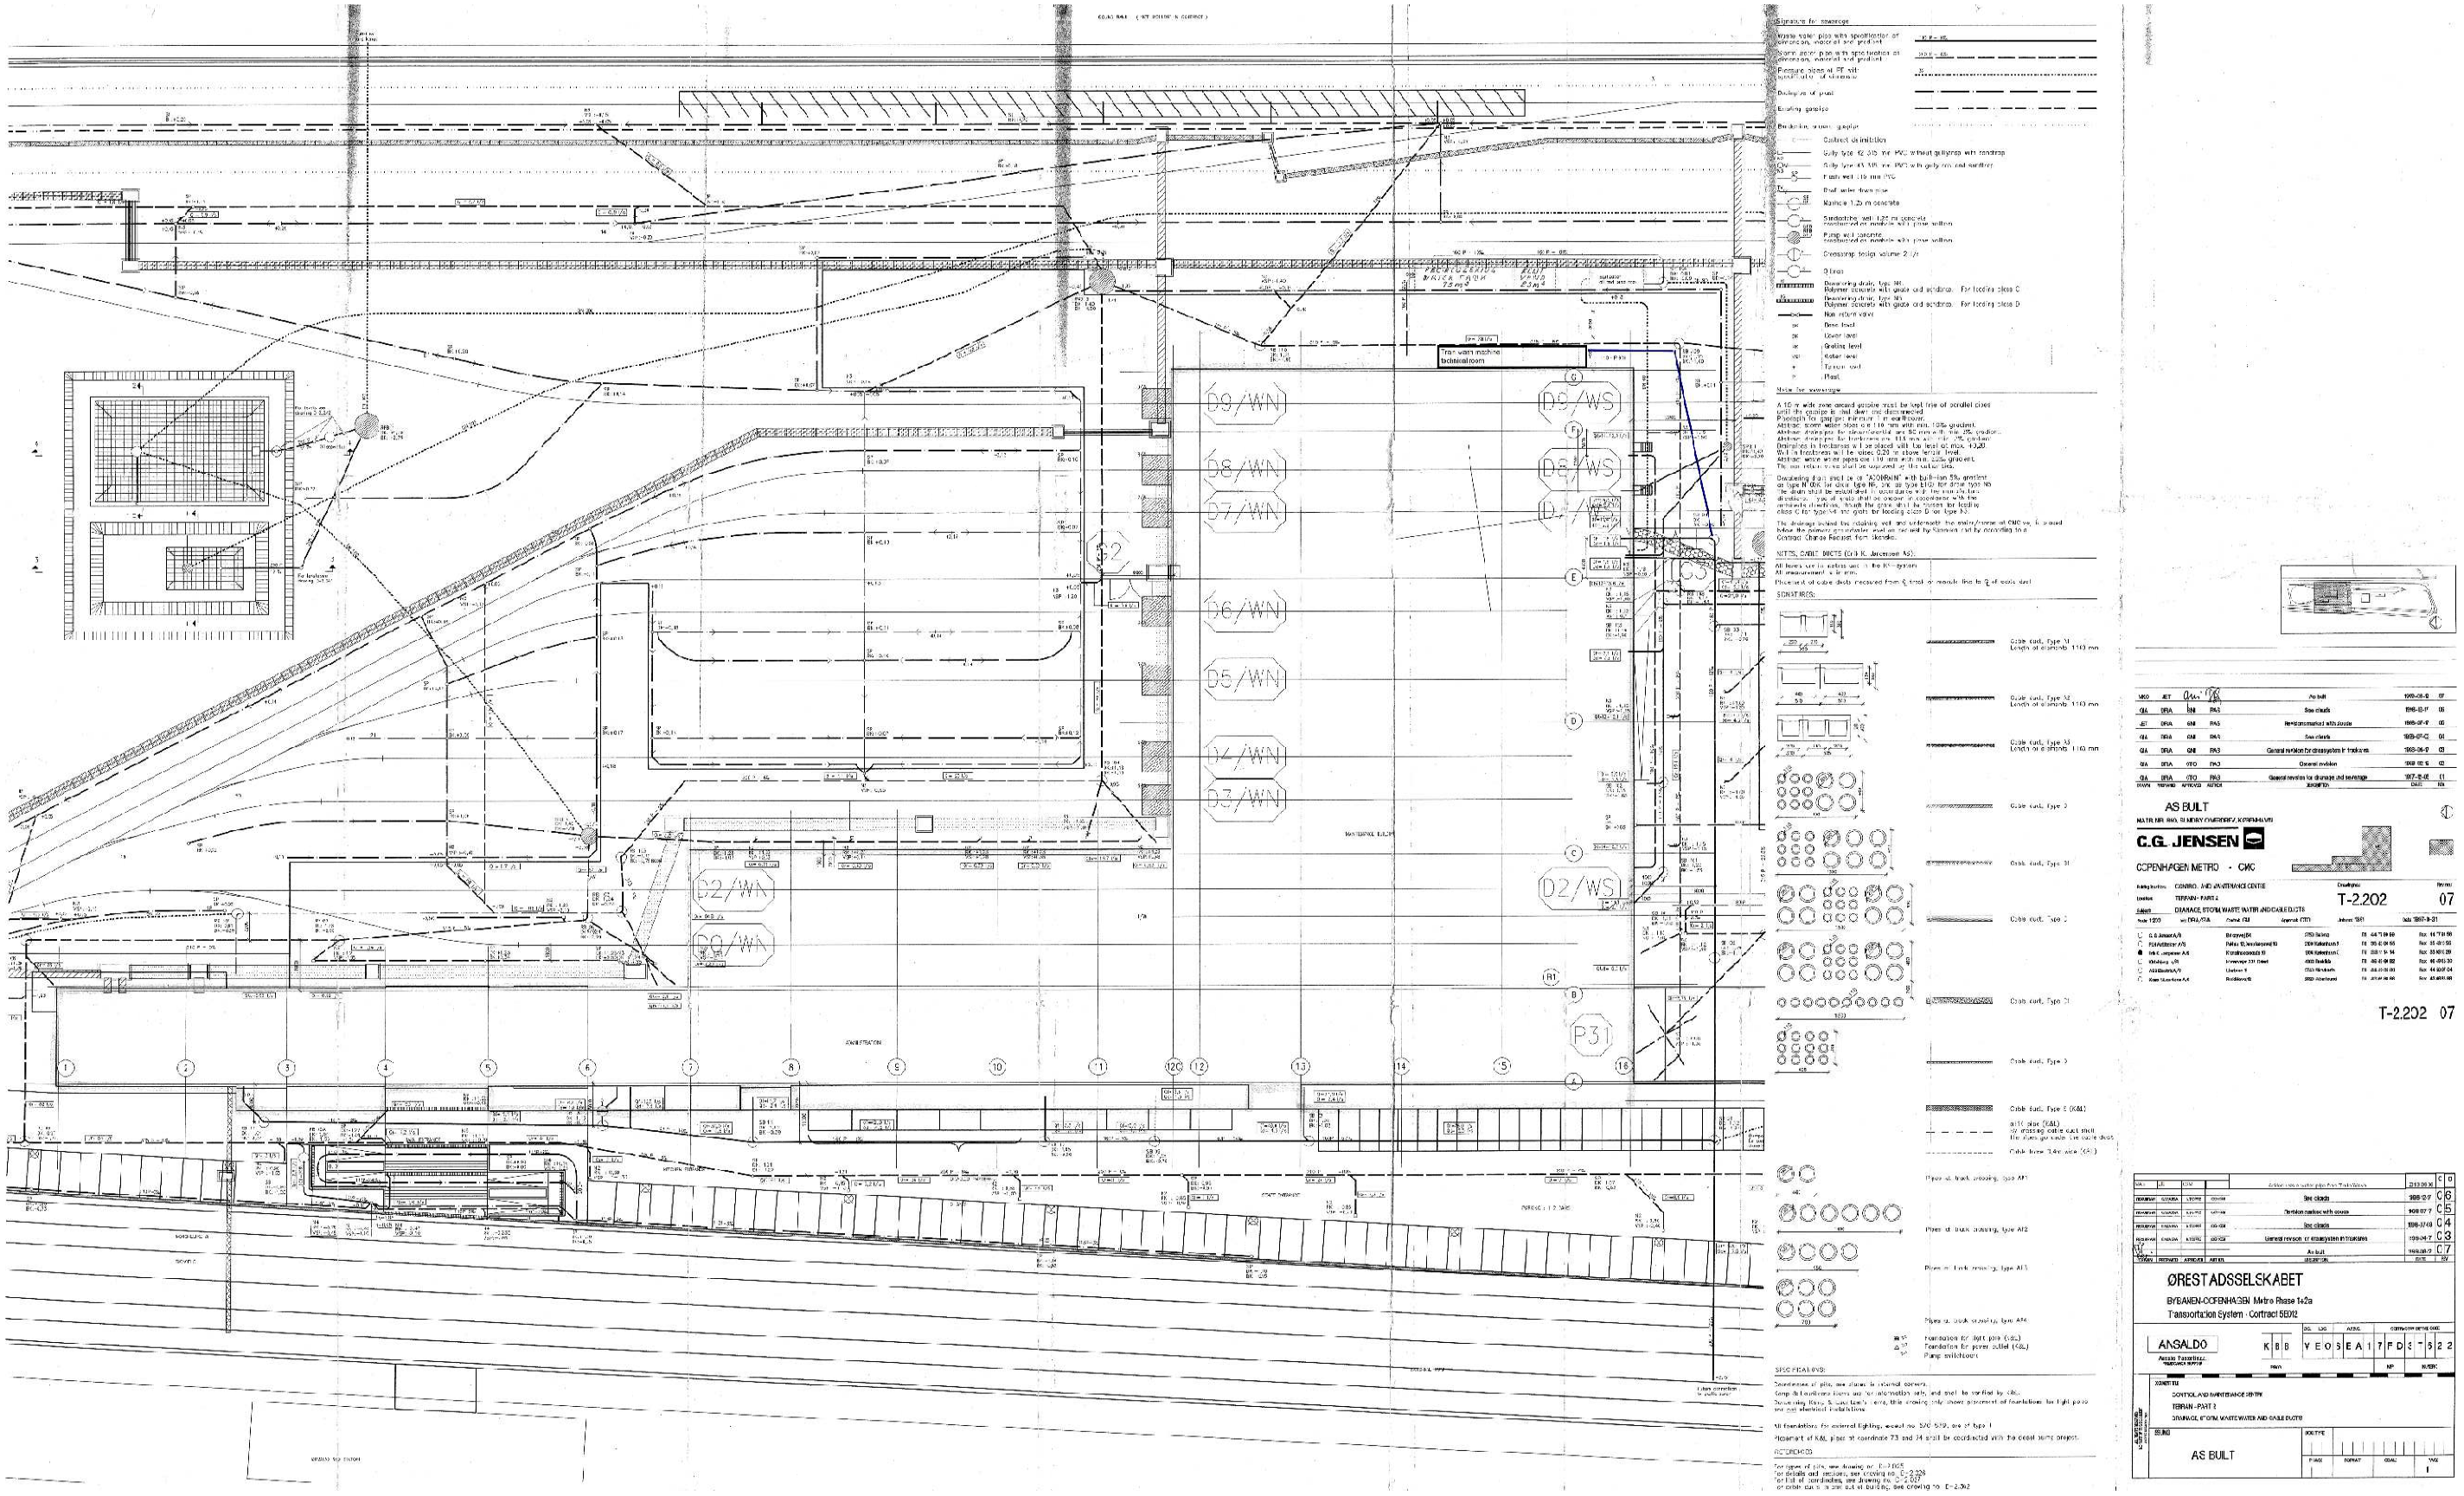
AS BUILT
C.G. JENSEN
COPENHAGEN METRO - CMC
T-2.202 07
ØRESTADSSELSKABET
BYBANEN-KØBENHAVN Metro Røde 1+2a
Transportation System - Contract 5502
ANSALDO
AS BUILT